

PAGE SETUP?


Markups Submitted Engineer1 11/15/2018

Revision Submitted Bim1 11/15/2018




www.autodesk.com/revit

Consultant Address Address Phone Fax e-mail	Consultant Address Address Phone Fax e-mail
Consultant Address Address Phone Fax e-mail	Consultant Address Address Phone Fax e-mail

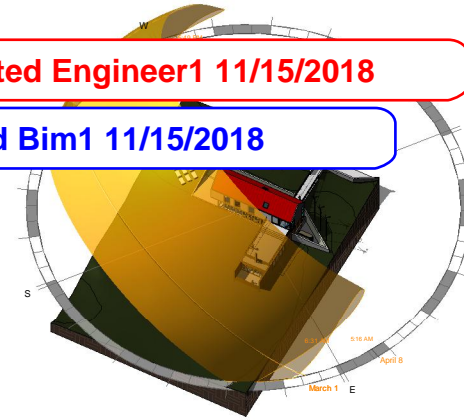

2 Solar Analysis

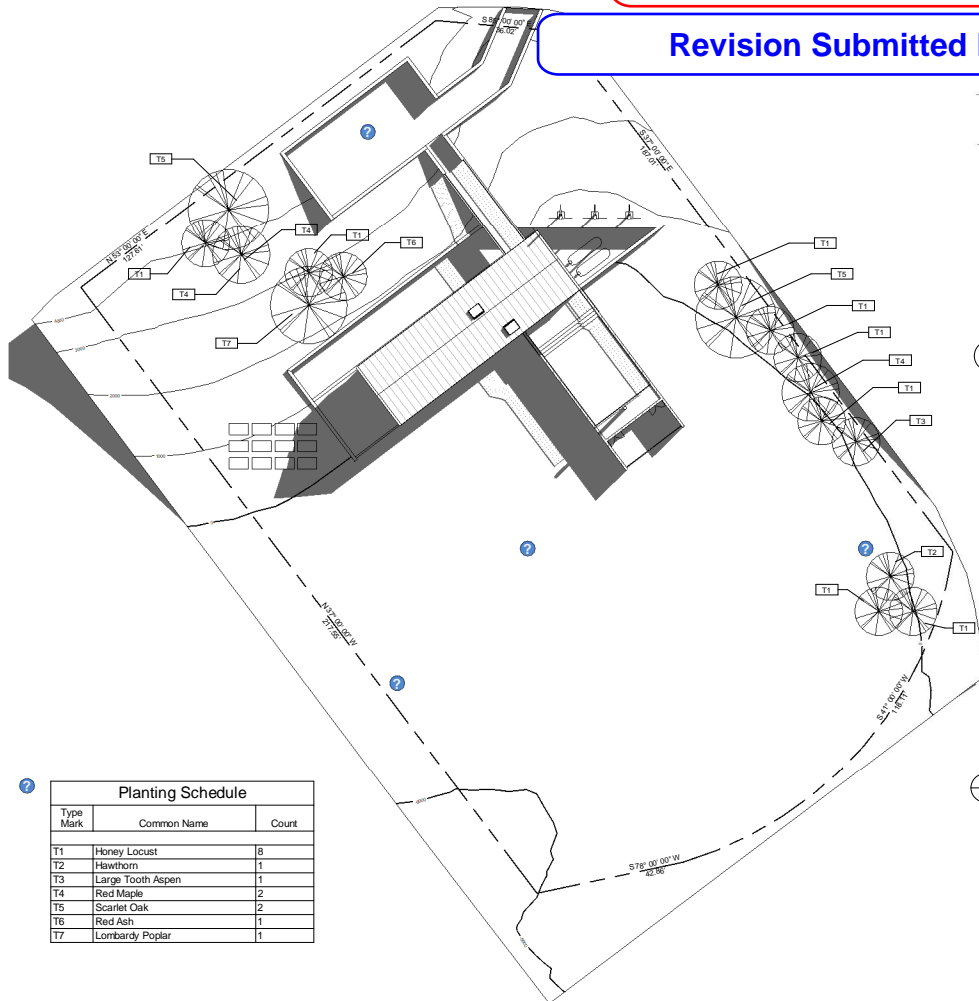

Planting Schedule

Type Mark	Common Name	Count
T1	Honey Locust	8
T2	Hawthorn	1
T3	Large Tooth Aspen	1
T4	Red Maple	2
T5	Scarlet Oak	2
T6	Red Ash	1
T7	Lombardy Poplar	1

1 Site

1 : 200

Autodesk
Sample House

Site Plan

Project number	001-00
Date	Issue Date
Drawn by	SM
Checked by	JLH
A101	
Scale	1 : 200

11/15/2018 10:10:05 AM